

AS BUILT
 Date Surveyed: January 28, 2009
 Project No.: CR200810791
 SEC4: 70097223
 Field Acceptance Date:
 File No.:


SUMMARY OF QUANTITIES				
ITEM	UNIT	PLAN	AS-BUILT	CONTRACT NO.
Street				
Fine Grading	S.Y.	17,782	17,782	12
CG-1 Curb and Gutter (Wet)	L.F.	7,572	7,572	13
2" Asphalt Surface	S.Y.	15,144	15,144	14
9" Asphalt Base	S.Y.	15,144	15,144	14
8" Portland Cement Concrete	S.Y.	973	973	14
5' Sidewalk	L.F.	7,861	7,861	15
White Directional Arrows Thermoplastic	Ea.	19	19	16
24" Thermoplastic Stop Bar	Ea.	1	1	16
4" Dashed White Thermoplastic	L.F.	320	320	16
4" Double Solid Yellow Thermoplastic	L.F.	323	323	16
4" Double Yellow w/ Solid and Dashed (Inside) Thermoplastic	L.F.	7,036	7,036	16
Stop Sign	Ea.	1	1	17
Storm				
Std. Curb Inlet (5'x3' Inside)	Ea.	12	12	18
Extra Depth on 5'x3' Curb Inlet	V.F.	151.88	151.90	18
Std. Curb Inlet (6'x5' Inside)	Ea.	1	1	18
Extra Depth on 6'x5" Curb Inlet	V.F.	14.53	14.80	18
Std. Curb Inlet (7'x5' Inside)	Ea.	1	1	18
Extra Depth on 7'x5" Curb Inlet	V.F.	14.37	14.45	18
Std. Curb Inlet (8'x5' Inside)	Ea.	1	1	18
Extra Depth on 8'x5" Curb Inlet	V.F.	14.88	14.90	18
Std. Manhole (8' Dia. Inside)	Ea.	1	1	18
Extra Depth on 8' Dia. Manhole	V.F.	14.87	15.25	18
24" RCP End Section	Ea.	1	1	18
36" RCP End Section	Ea.	3	3	18
54" RCP End Section	Ea.	1	1	18
24" RCP (Class III, Wall B)	L.F.	187.76	187.39	18
30" RCP (Class III, Wall B)	L.F.	90.00	90.23	18
36" RCP (Class III, Wall B)	L.F.	348.32	347.55	18
42" RCP (Class III, Wall B)	L.F.	571.71	570.87	18
48" RCP (Class III, Wall B)	L.F.	165.37	166.84	18
54" RCP (Class III, Wall B)	L.F.	200.15	198.01	18
Grouted Rip-Rap (d ⁵⁰ =1.25)	S.Y.	156	156	18
Erosion Control				
Inlet Protection	Ea.	16	16	19

Note:
 Street embankment and rough grading were included with the previous Street Preliminary Permit SEC 5 70095944.

Summary of Quantities as indicated above and any quantities as shown within the plans have been provided for permitting purposes only and are not intended for use in preparation of contract documents. Quantities intended for, but not limited to, the preparation of proposals and bid documents shall be independently evaluated by the estimating party based upon the contents of these plans.

01-25-08	R.J.S.	Added Sheet
04-28-08	R.J.S.	Revised pavement quantities
06-20-08	R.J.S.	Revised per city comments
08-26-08	R.J.S.	Revised contract numbers
02-09-09	R.J.S.	AS BUILT
DATE	P.E. SIGNATURE	DESCRIPTION

QUANTITIES
CENTERPOINT-KCS
INTERMODAL CENTER

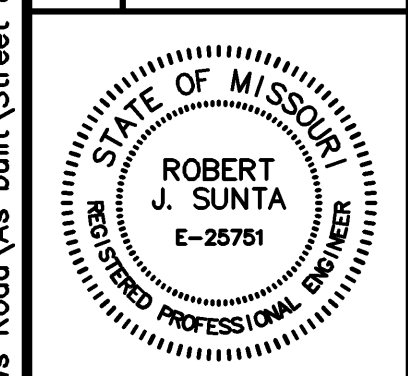

Reviewed By: S.E.C.
 Designed By: R.J.S.
 Drafted By: J.W.W.

Lutjen Project No.: 07216

LUTJEN

8350 N. Saint Clair Ave.
 Kansas City, MO 64151
 816.587.4320
 816.587.1393 fax
 www.lutjen.com

surveying
 planning
 engineering
 landscape architecture

Sheet No.:
25

Location: N:\Engineering\Richard Gebaur - 07165 & 07166\Drafting\Andrews Road\As Built\Street & Storm\QUA - 07216.dwg