


NOT AS BUILT



- EXISTING 2' CONTOURS
- EXISTING 10' CONTOURS
- FUTURE 2' CONTOURS
- FUTURE 10' CONTOURS
- PROPOSED 2' CONTOURS
- PROPOSED 10' CONTOURS
- EXISTING STORM SEWER
- PROPOSED STORM SEWER
- FUTURE STORM SEWER
- EXISTING SANITARY SEWER
- PROPOSED SANITARY SEWER
- FUTURE SANITARY SEWER
- EXISTING WATER MAINS
- PROPOSED WATER MAINS
- FUTURE WATER MAINS
- EXISTING RIGHT-OF-WAY
- PROPOSED RIGHT-OF-WAY
- FUTURE RIGHT-OF-WAY
- PROPERTY LINE


Under Current Land Disturbance Permit SEC 8 70095932.

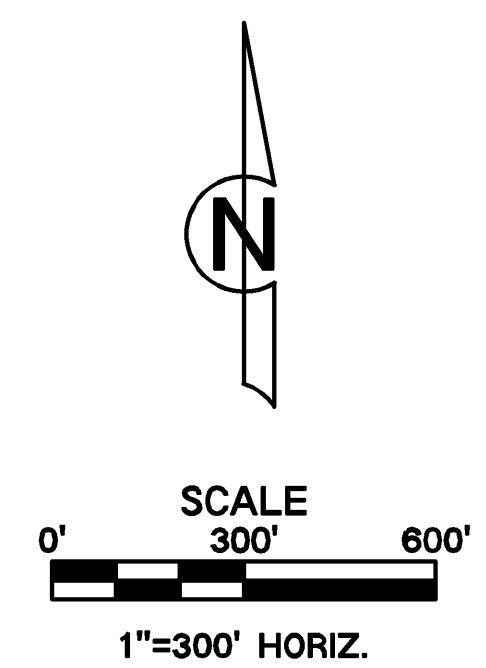

GENERAL NOTES:
 EXISTING CONTOURS SHOWN ON THIS PLAN REPRESENT THE FINISH GRADES BY OTHERS AS PART OF THE PLAN SET TITLED: CENTERPOINT-KCS INTERMODAL CENTER PUBLIC IMPROVEMENT PLANS SITE GRADING, LAND DISTURBANCE, STORM SEWER, & PRELIMINARY STREET PLANS

DATE	P.E. SIGNATURE	DESCRIPTION
06-07-07	R.J.S.	Prepared for Review.
01-25-08	R.J.S.	Revised site grading
05-20-08	R.J.S.	Revised per City Comments

GRADING PLAN
CENTERPOINT-KCS INTERMODAL CENTER

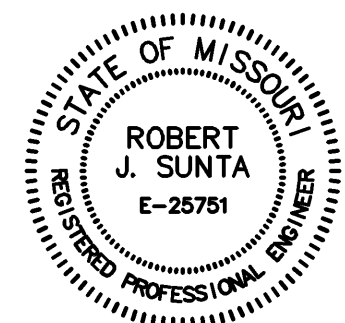

Reviewed By: S.E.C.
 Designed By: R.J.S.
 Drafted By: J.W.W.
 Lutjen Project No.: 07216



Sheet No.:
27

Location: N:\Engineering\Richard Gebaur - 07165 & 07166\Drafting\Andrews Road\As Built\Street & Storm\GRI - 07216.dwg