


PAVEMENT MARKING - ANDREWS ROAD
Sta. 42+00.00 to Sta. 50+36.70

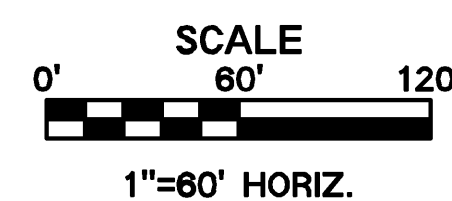


- ① - 4" Double Solid Yellow Thermoplastic
- ② - 24" White Thermoplastic Stop Bar
- ③ - White Directional Arrows Thermoplastic
- ④ - 4" Double Yellow w/ Solid & Dashed (Inside) Thermoplastic (See Detail on Previous Sheet)
- ⑤ - 4" Dashed White Thermoplastic
- ⑥ - 4" Solid White Thermoplastic

Note: Contractor is to notify Mr. Eddie Shields, Pavement Marking Technician, Street and Traffic Division - Public Works at 513-2672 at least 48 hours prior to placement of markings for inspection of striping layout.

DATE	P.E. SIGNATURE	DESCRIPTION
10-01-07	R.J.S.	Prepared for Review.
01-25-08	R.J.S.	Revised striping layout
05-20-08	R.J.S.	Revised striping layout
06-25-08	R.J.S.	Revised striping layout

PAVEMENT MARKING PLAN
CENTERPOINT-KCS
INTERMODAL CENTER

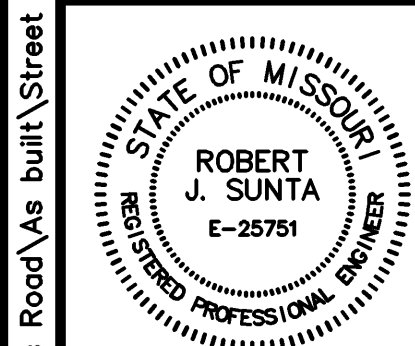

Reviewed By:	S.E.C.
Designed By:	R.J.S.
Drafted By:	J.W.W.
Lutjen Project No.: 07165	

LUTJEN

8350 N. Saint Clair Ave.
Kansas City, MO 64151
816.587.4320
816.587.1393 fax
www.lutjen.com

surveying
planning
engineering
landscape architecture

Location: N:\Engineering\Richard Gebaur - 07165 & 07166\Drafting\Andrews Road\As built\Street & Storm\PM1- 07216.dwg